


N ————
 POSTED TO ~~BS~~ BASS
 BY BS DATE 11/2001

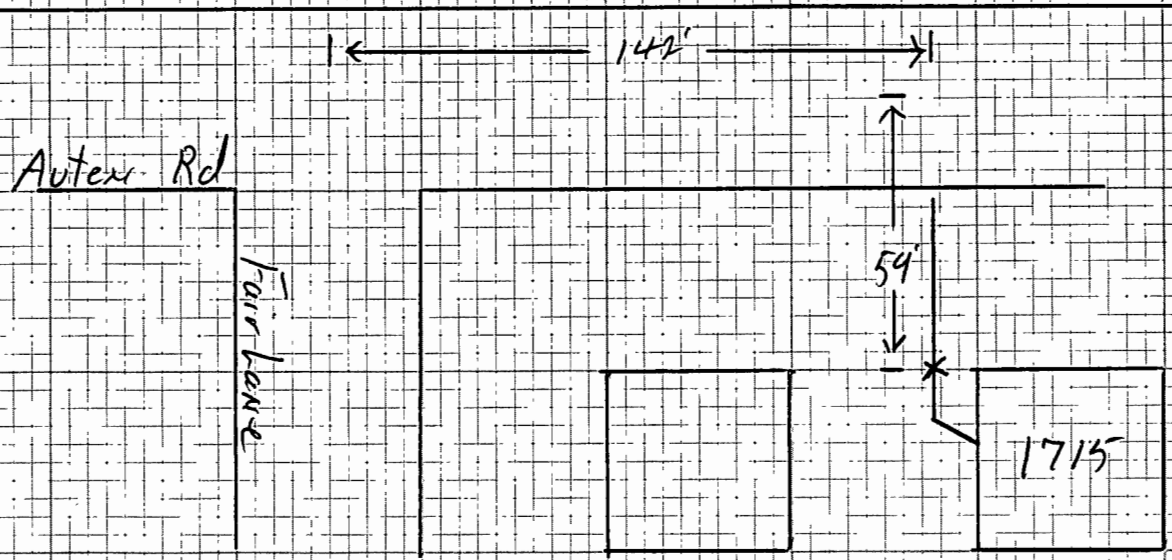

PSNC ENERGY					AS-BUILT			
DRAWN BY:	J Shuford		STREET	SIZE	TYPE	LENGTH	SIZE/TYPE OF ANODES	
FUSION BY:			1715 Autex Rd	3/4	C/W		1"	
TESTED BY:								
WITNESS:								
TEST PRESS.	DURATION	P/S READ.	CITY NO.	KEY NO.	GRID/SHT NO.	CP NO.	DATE	
		-1.000	700	46	AD-34	ISO	11-1-01	
CITY			WORK ORDER NO.	UNIT	DEPT.	ACCOUNT	RES.	PROJECT
Gastonia								0000812
								ACT.