


POSTED TO ~~CIS~~ **BASS**
 BY VJM DATE 11/06/01

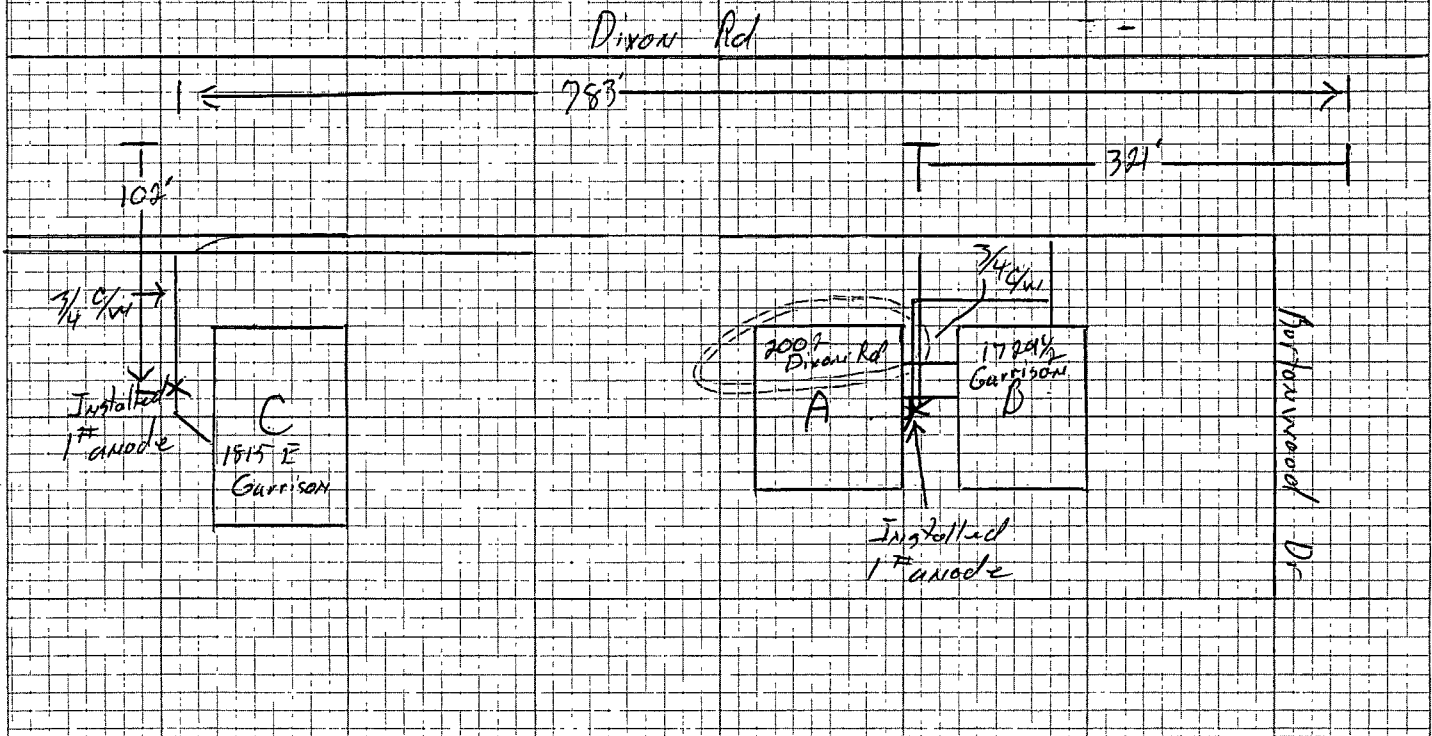

PSNC ENERGY					AS-BUILT				
DRAWN BY:	J Shuford		STREET	SIZE	TYPE	LENGTH	SIZE/TYPE OF ANODES		
FUSION BY:			Dixon Rd & Burtonwood	3/4	C/W		2-1#		
TESTED BY:									
WITNESS:									
TEST PRESS.	DURATION	P/S READ.	CITY NO.	KEY NO.	GRID/SHT NO.	CP NO.	DATE		
		-6.50	700	56	AK-33	1417	10-12-01		
CITY			WORK ORDER NO.	UNIT	DEPT.	ACCOUNT	RES.	PROJECT	
Gastonia			50139783					0029269	
								ACT.	