


N. Malvern

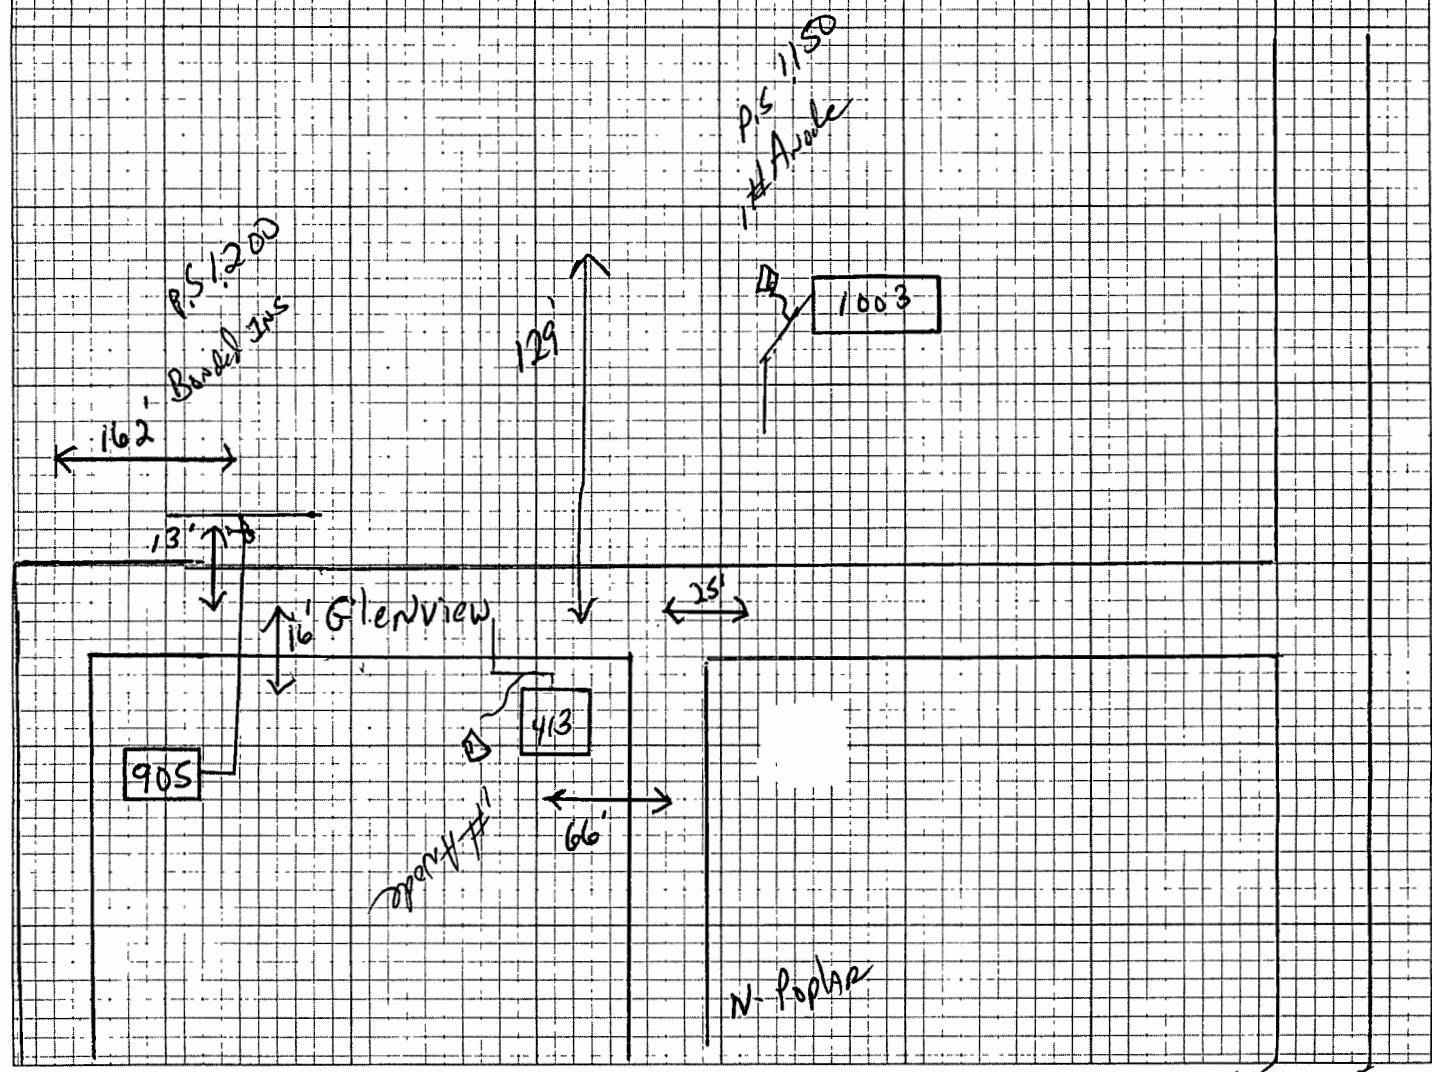

PSNC ENERGY					AS-BUILT			
DRAWN BY:	S. Moore		STREET		SIZE	TYPE	LENGTH	SIZE/TYPE OF ANODES
FUSION BY:			1003 Glenview		3/4	clw	2/S	1-1#
TESTED BY:			413 N. Poplar		3/4	clw	2/S	1-1#
WITNESS:			905 Glenview		3/4	clw	Buried	-
TEST PRESS.	DURATION	P/S READ.	CITY NO.	KEY NO.	GRID/SHT NO.	CP NO.	DATE	
		1150	700	SL6	AH-31	3009	5-6-02	
CITY			WORK ORDER NO.	UNIT	DEPT.	ACCOUNT	RES.	PROJECT
GASTON			195325110831		177	5		29193

9210051697703