


Deerwood DR

THIS IS I/S

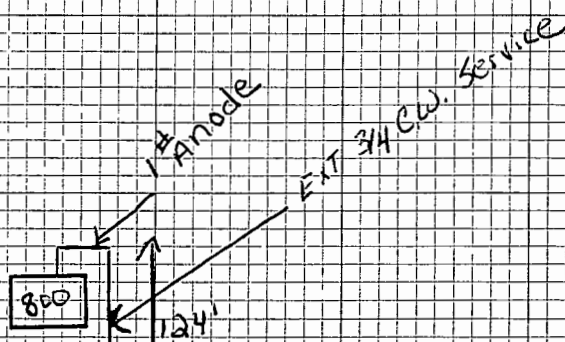

158'

IMPERIAL DR

EXT 2" CW main

POSTED TO ~~GIS~~ ~~BASS~~
BY VFM DATE 1/2/01

PUBLIC SERVICE COMPANY of NORTH CAROLINA, Inc.

AS-BUILT

DRAWN BY:	S. Cartwell		STREET		SIZE	TYPE	LENGTH	SIZE/TYPE OF ANODES
FUSION BY:			800 Imperial DR		3/4	C/W		1#
TESTED BY:								
WITNESS:								
TEST PRESS.	DURATION	P/S READ.	K	LOC	ACCT	SUB	WORK ORDER NO.	DATE
		1.200	1	177	37600	031	50127120	4-19-01
CITY			CITY NO.	KEY NO.	GRID NO.	CP NO.	PROJECT NO.	
Gastonia			700	666	AL-35	1921	26788	