




Sandy Lane

POSTED TO GIS & BASS  
BY VFM DATE 1/2/01

Imperial DR

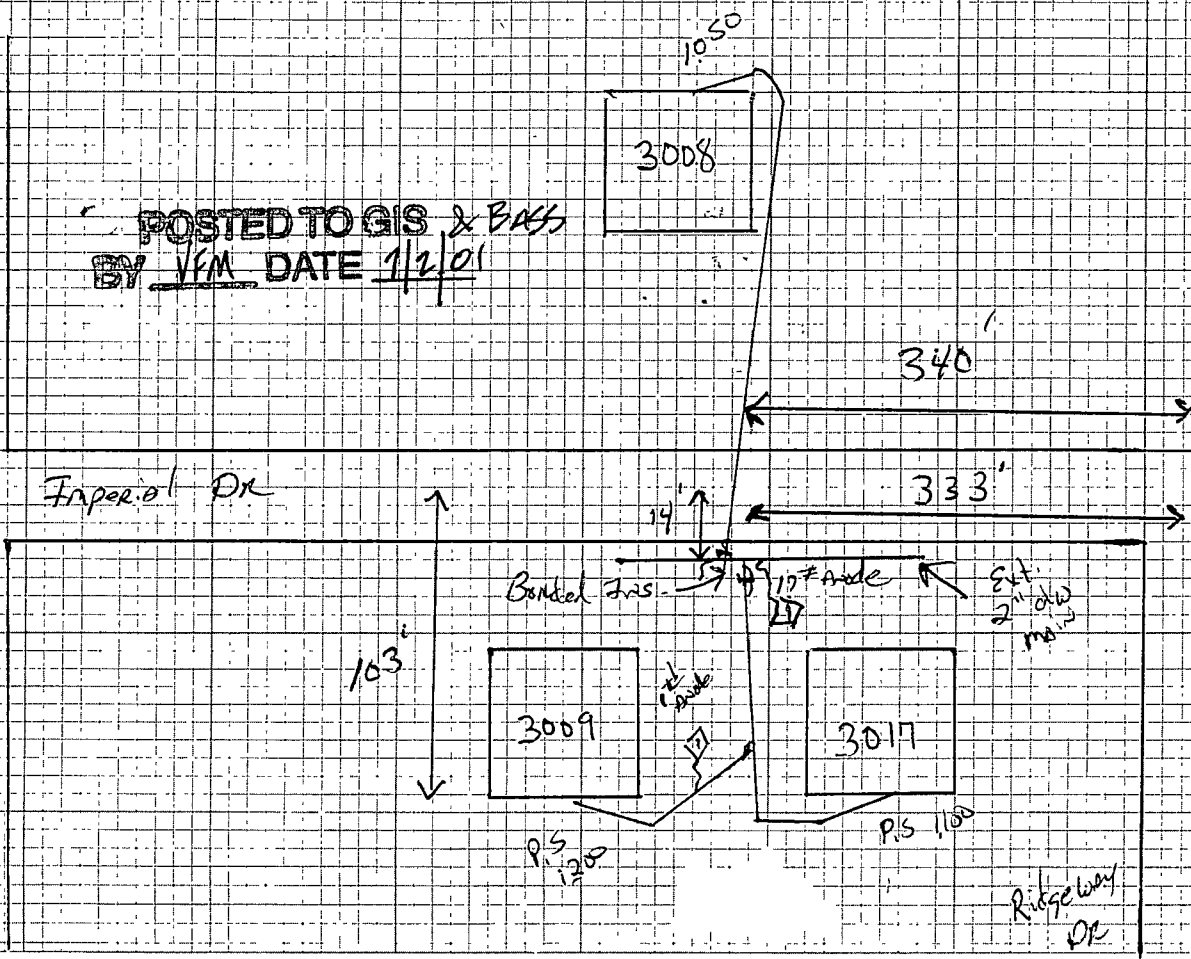

Ridge Way DR

PSNC ENERGY					AS-BUILT			
DRAWN BY:	S Elmore		STREET		SIZE	TYPE	LENGTH	SIZE/TYPE OF ANODES
FUSION BY:			3008 Imperial DR		3/4	clw		
TESTED BY:			3009 " "		3/4	clw		1-17# Anode
WITNESS:			3017 " "		3/4	clw		1-17# Anode
TEST PRESS.	DURATION	P/S READ.	CITY NO.	KEY NO.	GRID/SHT NO.	CP NO.	DATE	
		1050	700	66	AL-35	1721	5-10-01	
CITY			WORK ORDER NO.	UNIT	DEPT.	ACCOUNT	RES.	PROJECT
GASTONIA			50127120	1	171	376.00	031	26788
								0.34