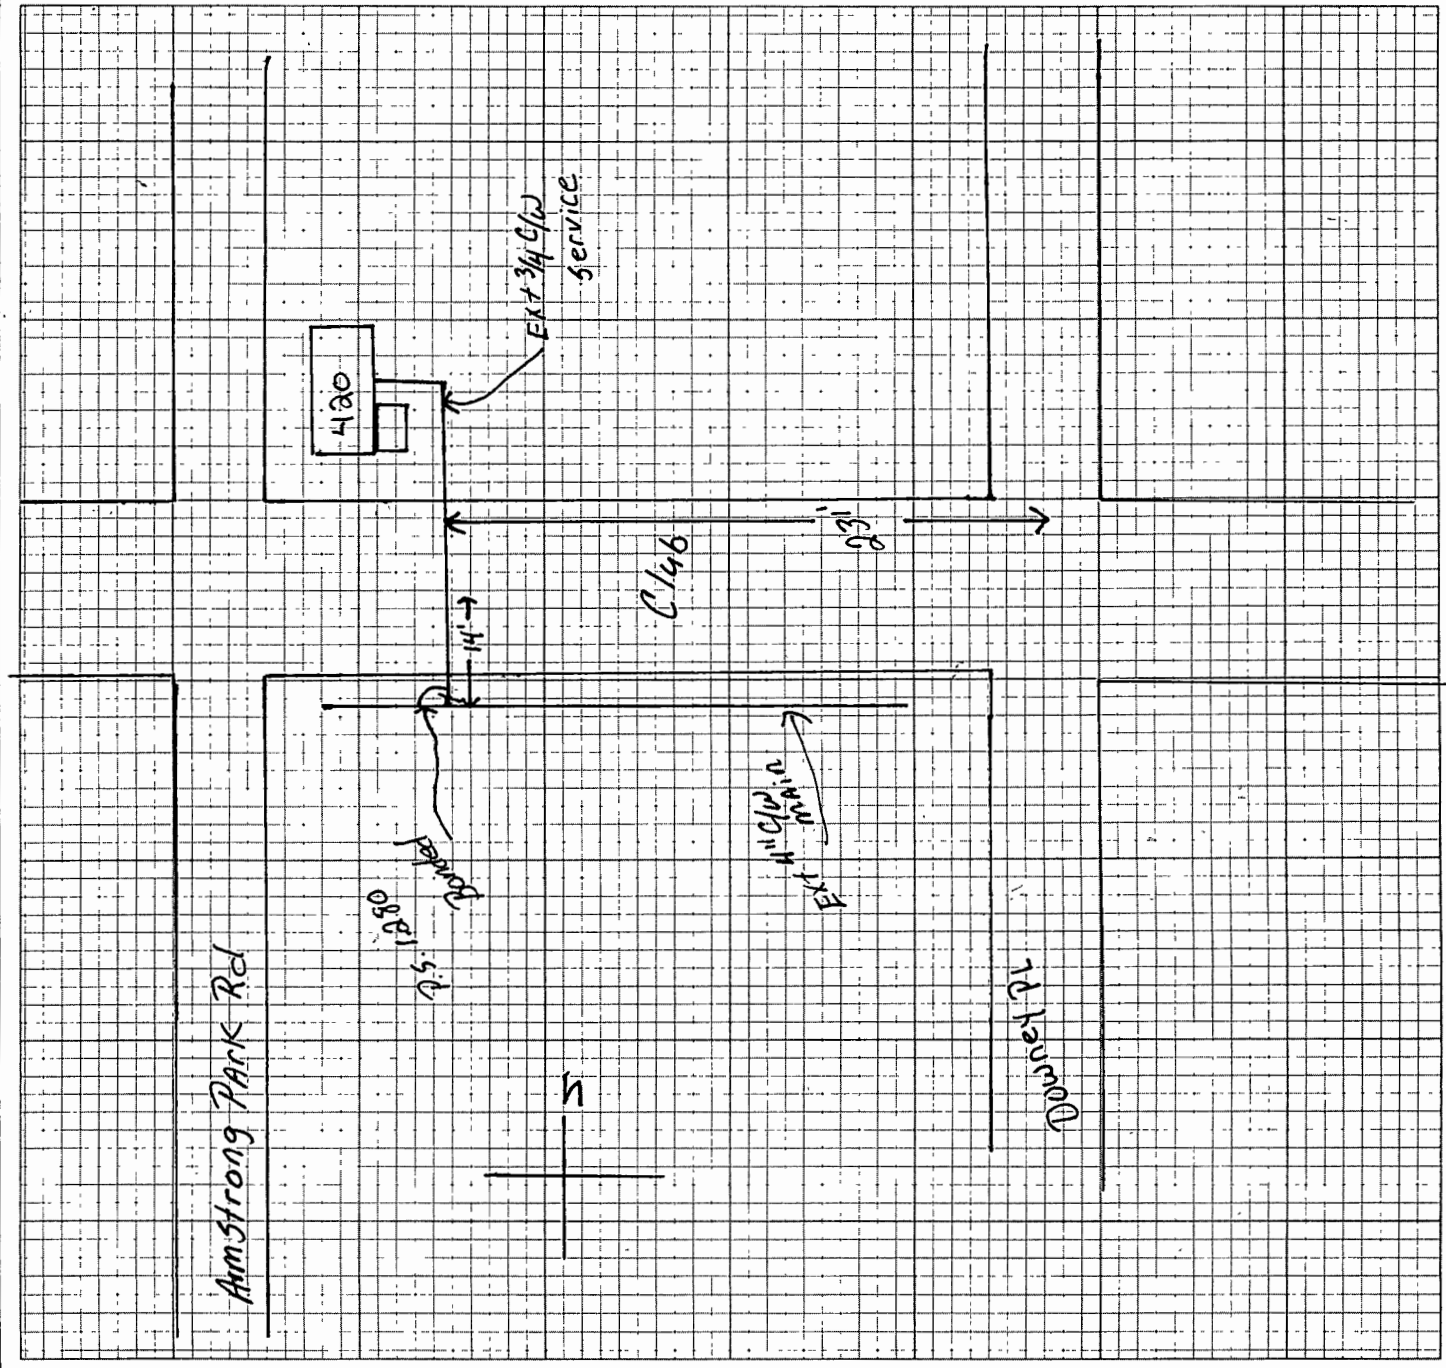

PSNC ENERGY						AS-BUILT		
DRAWN BY:	S. CALDWELL		STREET		SIZE	TYPE	LENGTH	SIZE/TYPE OF ANODES
FUSION BY:			420 Club LN		3/4	C/W	—	—
TESTED BY:								
WITNESS:								
TEST PRESS.	DURATION	P/S READ.	CITY NO.	KEY NO.	GRID/SHT NO.	CP NO.	DATE	
		1.280	700	56	AJ-33	1919	2-2-01	

CITY	WORK ORDER NO.	UNIT	DEPT.	ACCOUNT	RES.	PROJECT	ACT.
GASTONIA	50125066	1	177	37600	031	26787	034

E-6-8-00